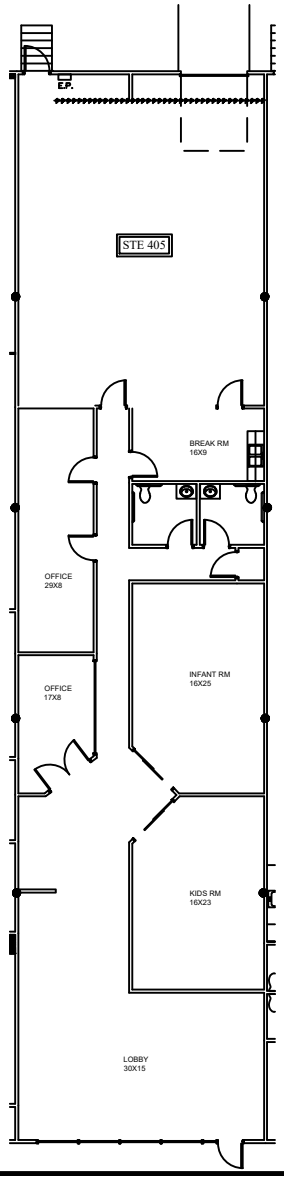

KEY PLAN

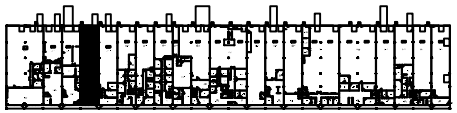

SCALE: N.T.S.

AS-BUILT PLAN--SUITE 405
4,050 RSF

14 PRYOR DRIVE
CHATTANOOGA, TN 37421

PLANS BY ADI, INC.

31 AUGUST 2021