LEGEND:

- EXISTING WALL TO REMAIN
- EXISTING WALL TO BE REMOVED
- NEW WALL
- TERMINATE WALL @ UNDERSIDE OF DECK ABOVE
- EXISTING DOOR TO REMAIN
- EXISTING DOOR TO BE REMOVED
- NEW DOOR
- EGRESS PATH/EXIT DOOR
- FE — FIRE EXTINGUISHER

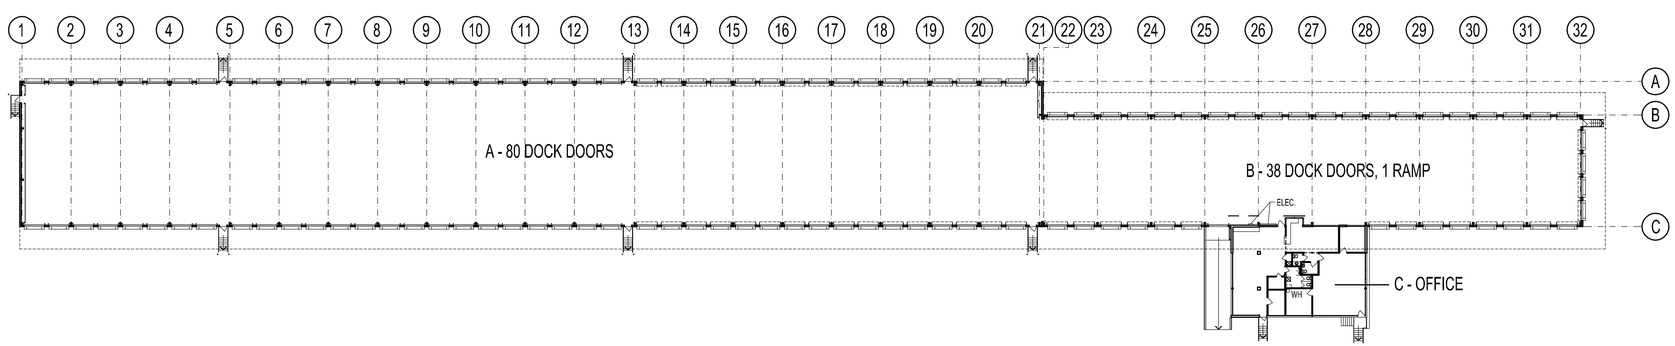

A - NEWER DOCK 455' x 65' = 29,705 S.F. 15' A.F.F. EAVE HT.
B - ORIGINAL DOCK 242' x 50' = 12,100 S.F. 13'-6" A.F.F. EAVE HT.
C - OFFICE 60'-10" x 40'-6" = 2,464 S.F. 11'-10" EAVE HT.
TOTAL DOORS 118 DOCK HIGH (6'W. x 10'H.)
1 DRIVE OUT RAMP

1 / 1.1 FLOOR PLAN
1/32" = 1'-0"

ARCHITECTURE
Planning • Consulting
Alsip & Associates PC
119 KING STREET
HAGERSTOWN, MD 21740
301-991-3554
chip@alsipandassociates.com

PROFESSIONAL CERTIFICATION: I CERTIFY THAT THESE DOCUMENTS WERE PREPARED OR APPROVED BY ME, & THAT I AM A DULY LICENSED ARCHITECT UNDER THE LAWS OF THE STATE OF MARYLAND, LICENSE #12116, EXPIRATION DATE 4-29-25.

SEAL

A+A Project #240360

As-Builts for:
WAREHOUSE & OFFICE
503 Mason Dixon Rd.
Greencastle, Pennsylvania 17225

DATE: 11-7-24
DRAWN BY: SD
DRAWING TITLE: AS-BUILT FLOOR PLAN

A1.1

COPYRIGHT 2024

PDF Created with deskPDF PDF Writer - Trial :: http://www.docudesk.com

A - NEWER DOCK 457' x 65' = 29,705 S.F. 15' A.F.F. EAVE HT.
B - ORIGINAL DOCK 242' x 50' = 12,100 S.F. 13'-6" A.F.F. EAVE HT.
C - OFFICE 60'-10" x 40'-6" = 2,464 S.F. 11'-10" EAVE HT.
TOTAL DOORS 118 DOCK HIGH (9'W. x 10'H.)
1 DRIVE OUT RAMP

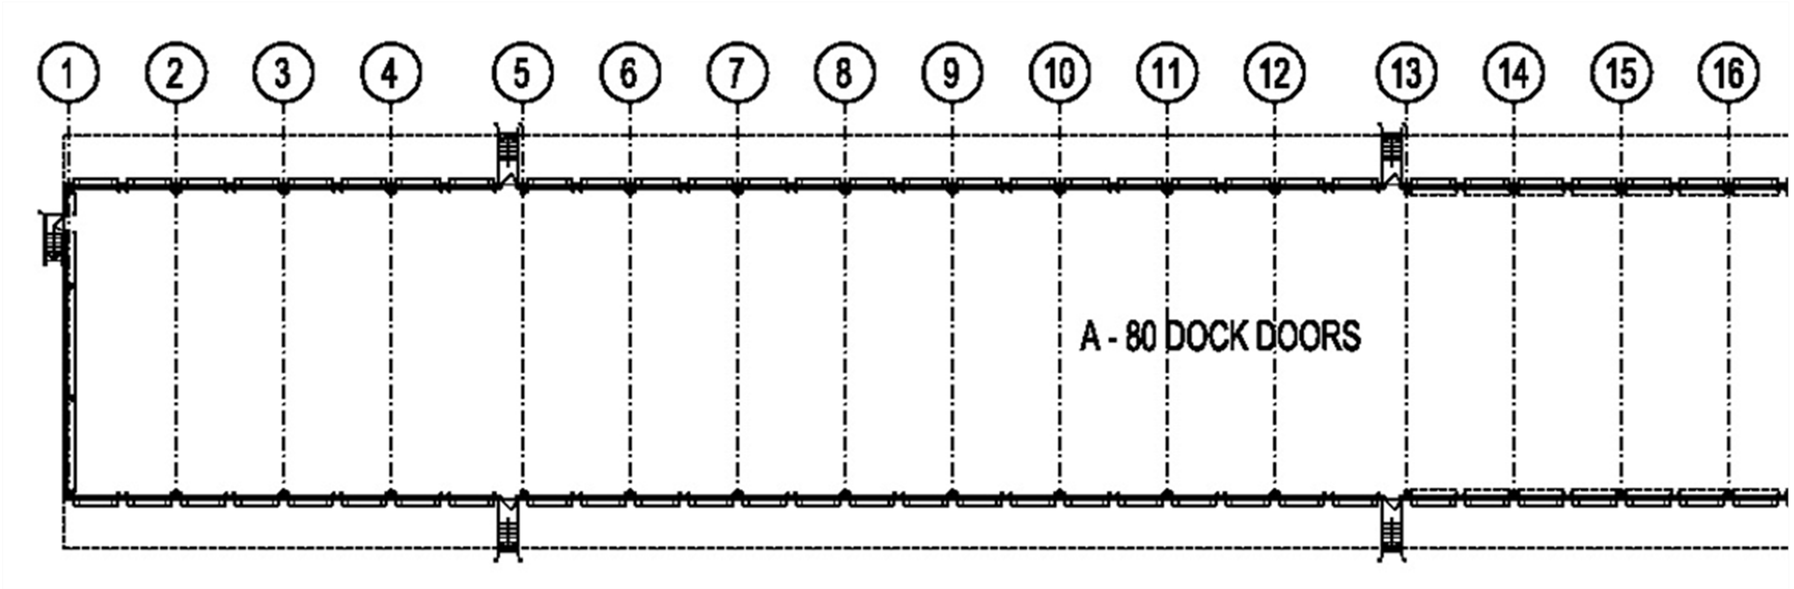

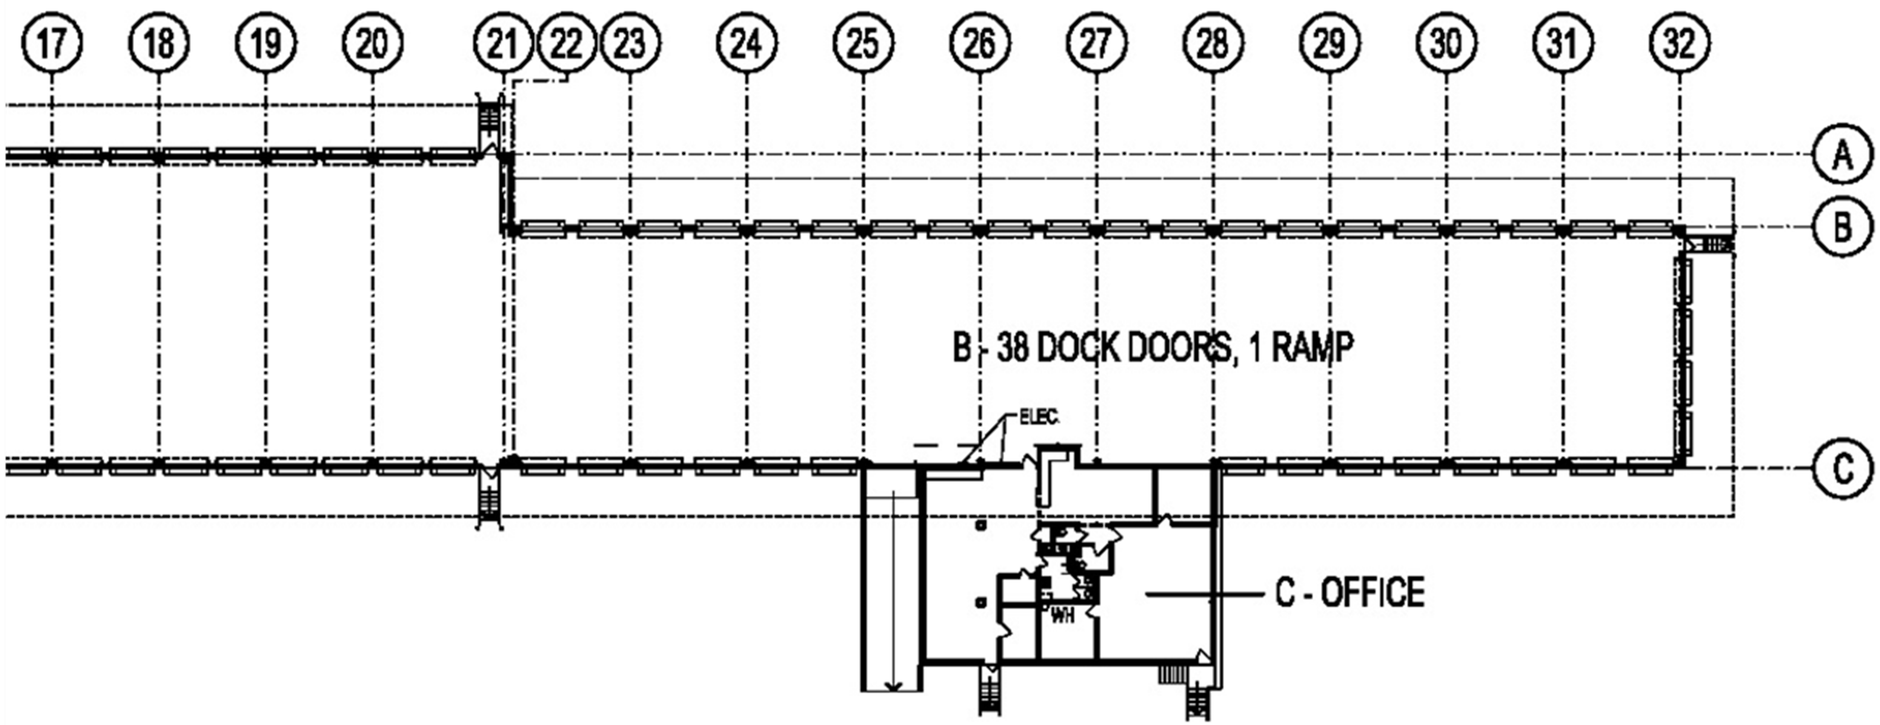

1 / 1.1 FLOOR PLAN
1/32" = 1'-0"

ARCHITECTURE
Planning • Consulting
Alsip & ASSOCIATES PC
119 KING STREET
HAGERSTOWN, MD 21740
301-991-3554
chip@alsipandassociates.com

PROFESSIONAL CERTIFICATION: I CERTIFY THAT THESE DOCUMENTS WERE PREPARED OR APPROVED BY ME, & THAT I AM A DULY LICENSED ARCHITECT UNDER THE LAWS OF THE STATE OF MARYLAND, LICENSE #12116, EXPIRATION DATE 4-29-25.

SEAL

A+A Project #240360

As-Builts for:
WAREHOUSE & OFFICE
503 Mason Dixon Rd.
Greencastle, Pennsylvania 17225

DATE: 11-7-24
DRAWN BY: SD
DRAWING TITLE:
AS-BUILT FLOOR PLAN

A1.1

COPYRIGHT 2024

PDF Created with deskPDF PDF Writer - Trial :: http://www.docudesk.com