US Highway 41
Neighboring building

Woods Edge Parkway
Parking

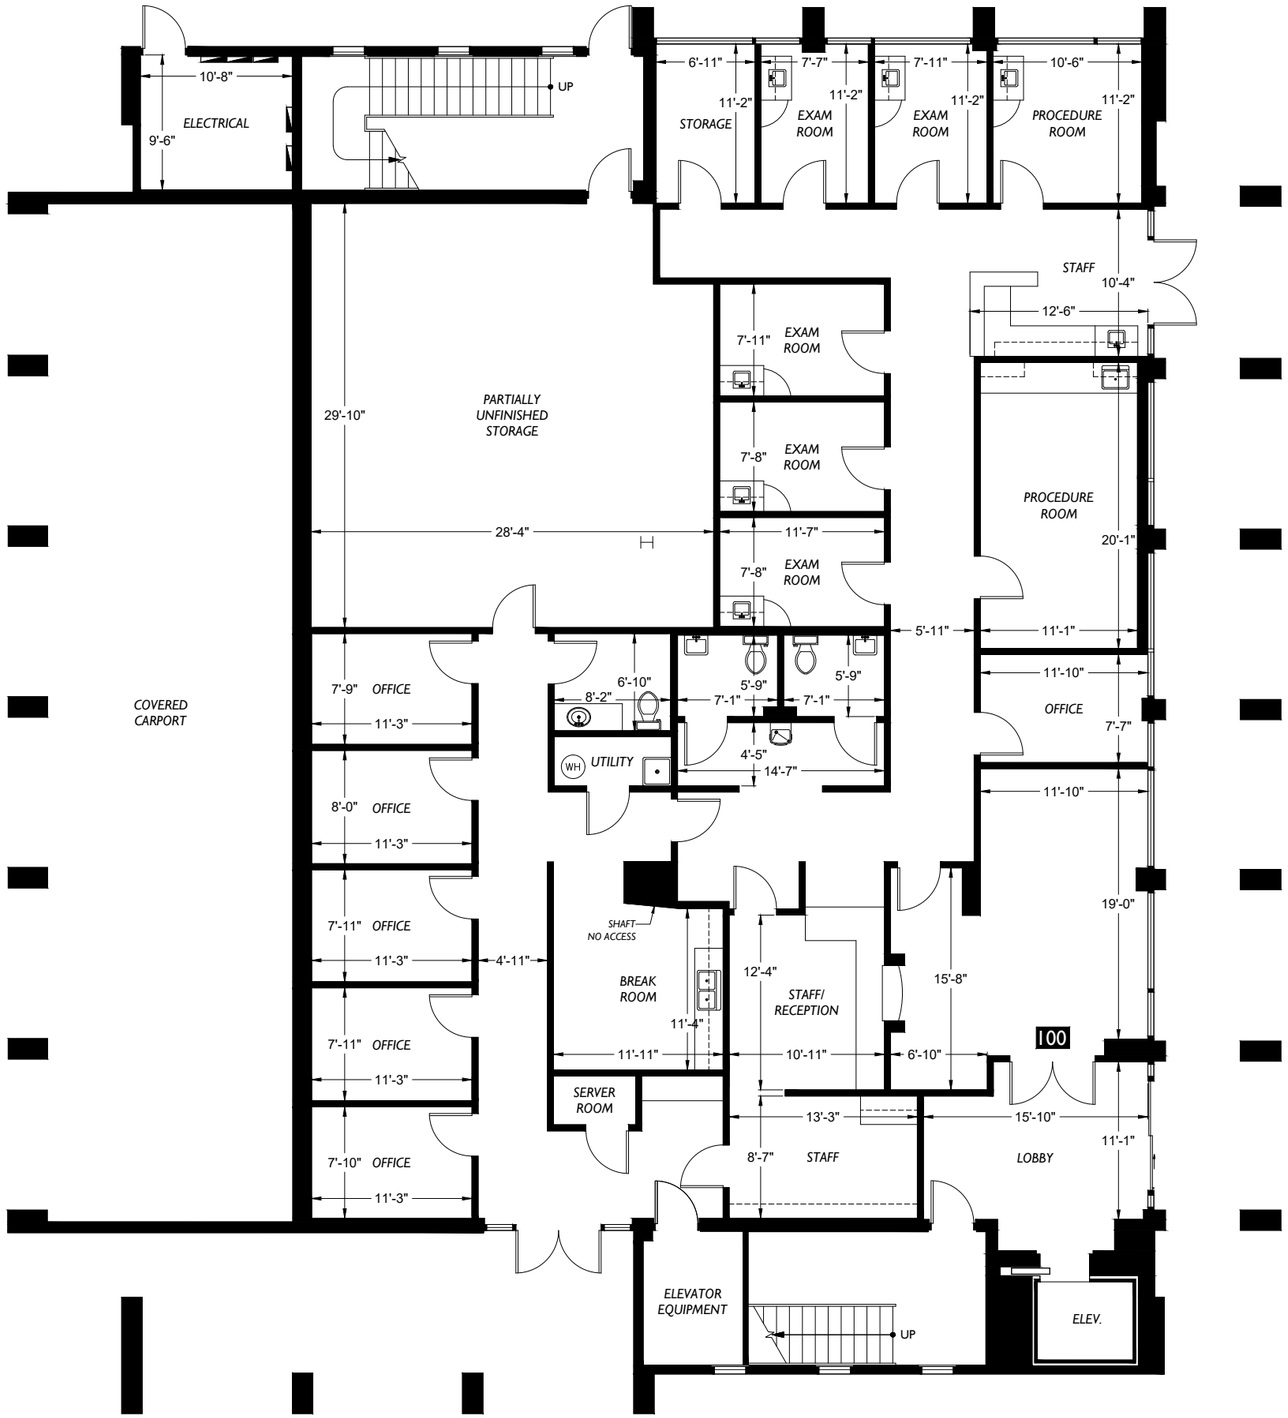

Parking

Parking

Genesis Care-Bonita Springs

Building Type: Medical Office Building

3291 Woods Edge Parkway
Bonita Springs, FL

Entrance

0 10 20 30

Scale: 3/32" = 1'-0"

2-D AS-BUILT FLOOR PLANS

2DFLOORPLANS.COM

371 NW Gilman Blvd.
Suite 140
Issaquah, WA 98027
425-677-7511

This drawing is an instrument of service and is the sole property of the client listed. Any alteration of this drawing without removal of references to 2-D As-Built Floor Plans, Inc. is prohibited.

Drawing scale and dimensions are provided for reference only. Refer to CAD files for exact measurements.

©2010 2-D As-Built Floor Plans, Inc. All Rights Reserved.

Project: C23-510

Date	Action
Project	
06-14-2023	Initial site measure
C23-510	

Client:
Community Healthcare Trust
3326 Aspen Grove Drive, Ste 150
Franklin, TN 37067

Site:
Genesis Care - Bonita Springs
3291 Woods Edge Parkway
Bonita Springs, FL

Floor Plan

1

Floor