300 McLaws Circle – Williamsburg, VA

First Floor Office - 2,042 RSF
As Built Floor Plans

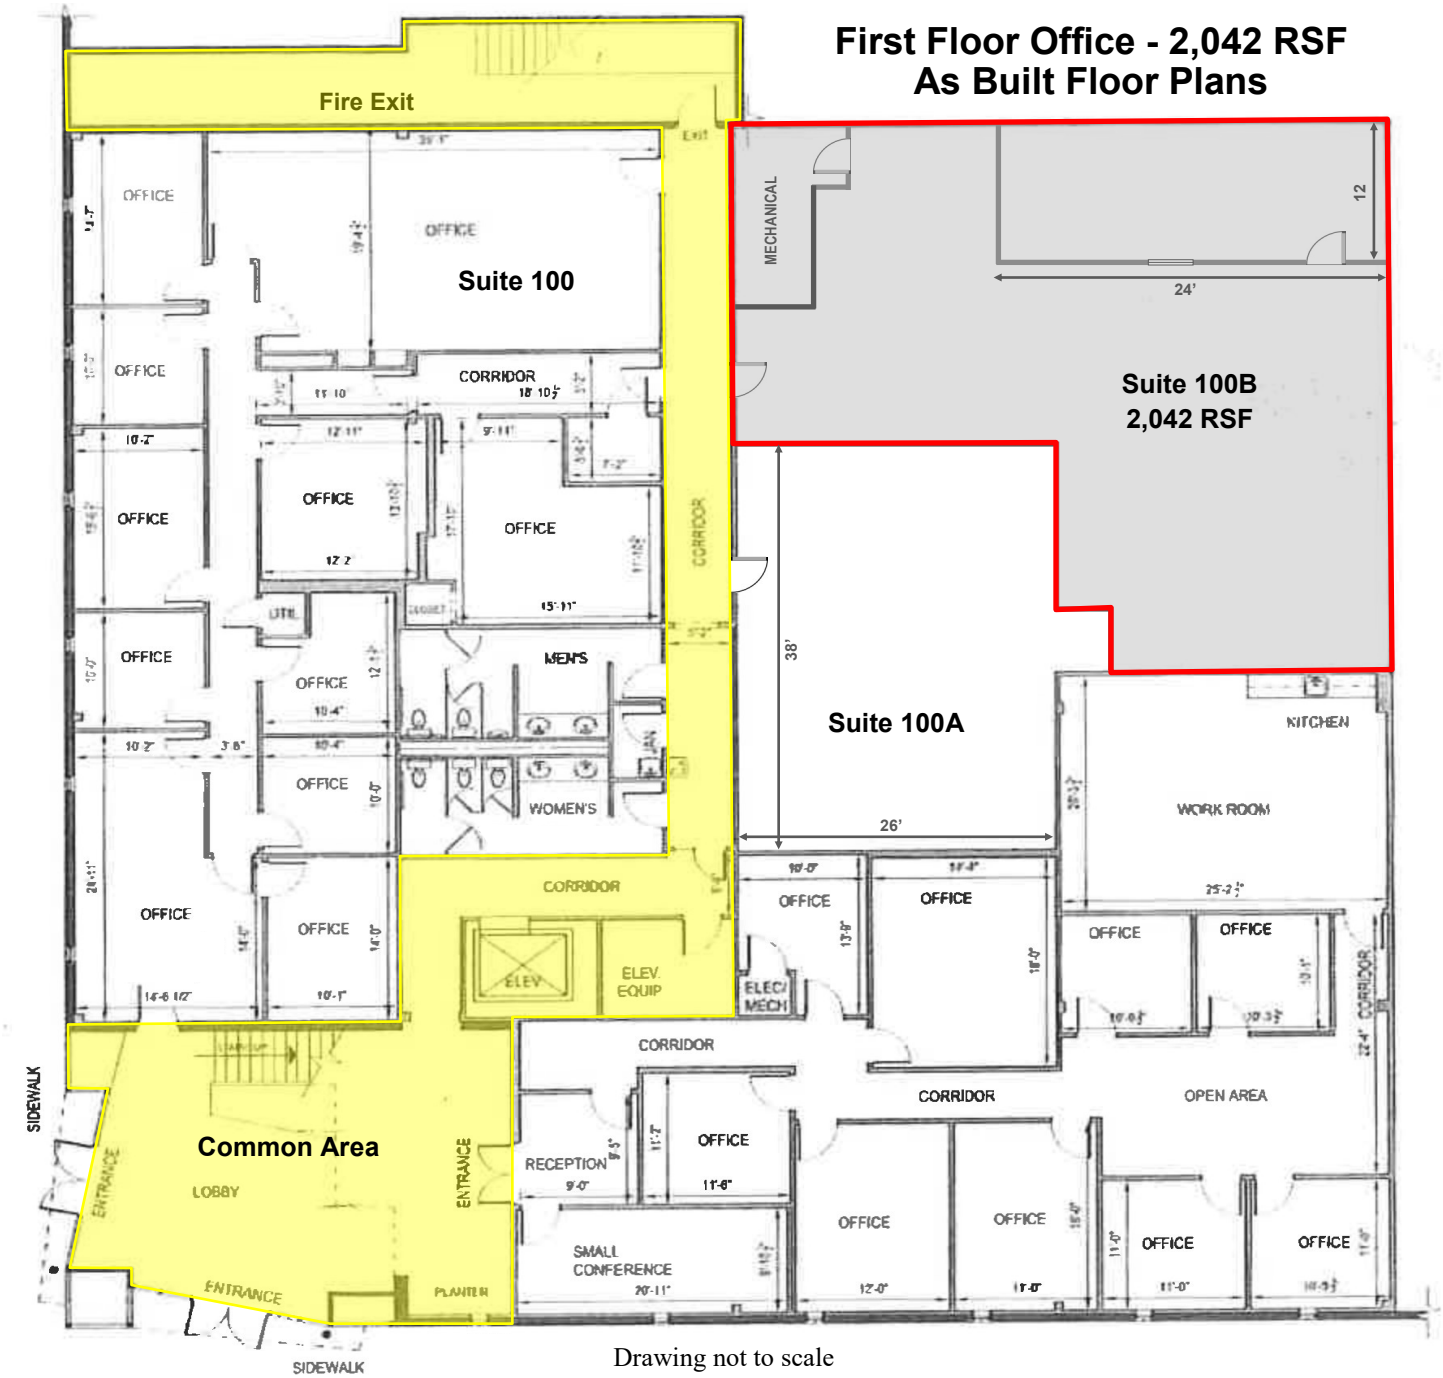

Drawing not to scale

For more information, contact:

Craig Read

fcr@readcompanies.com

(757) 865-6600

Disclaimer: This information is obtained from sources deemed to be reliable but is not warranted. This offer is subject to error, change, withdrawal and prior sale or lease.