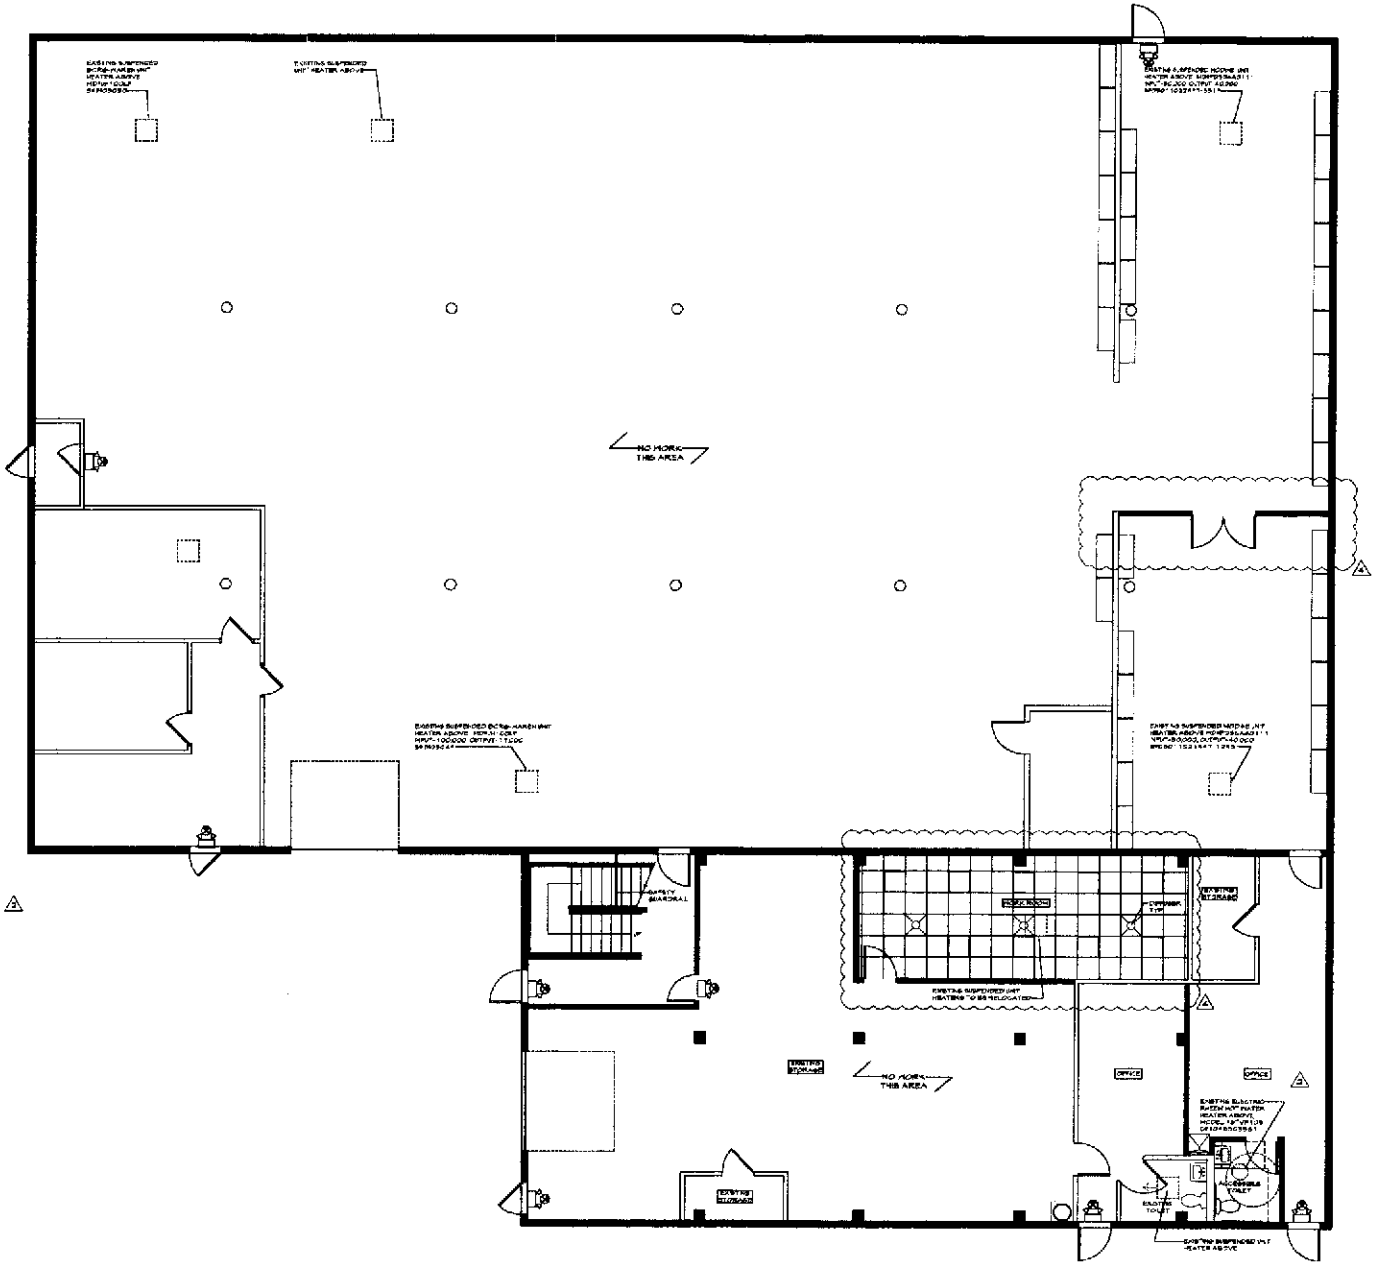

1 First Floor Mechanical Plan
Scale: 3/16" = 1'-0"

Project
Building Concepts
New Office
300 Broadway
Bethpage NY, 11714

Architect
[redacted]
KCG Architects
21 GRAND AVENUE SUITE 106
PALISADES PARK, NJ 07650
201 313 4860 FAX 201 313 4861
www.kcg-arch.com

Owner
Mr. Lou Alba
Building Concepts Inc.
300 Broadway
Bethpage, NY 11714
P: 516.333.4512 F:516.937.6880

DATE	ISSUE
08/05/13	FOR PERMIT

REV	DATE	ISSUE
1	12/24/13	DOB COMMENTS REV#1
2	01/10/14	DOB COMMENTS REV#2
3	01/30/14	DOB COMMENTS REV#3
4	01/11/21	AS-BUILT

NEW YORK LICENSE NUMBER # NY 031516-1

© 2021 KEVIN C GOYE AIA, LLC

Sheet Title
1ST FLOOR MECHANICAL PLAN

Scale	Drawn by
AS NOTED	AC
Project Number	Checked By
15044	KCG

Sheet Number
M1.0