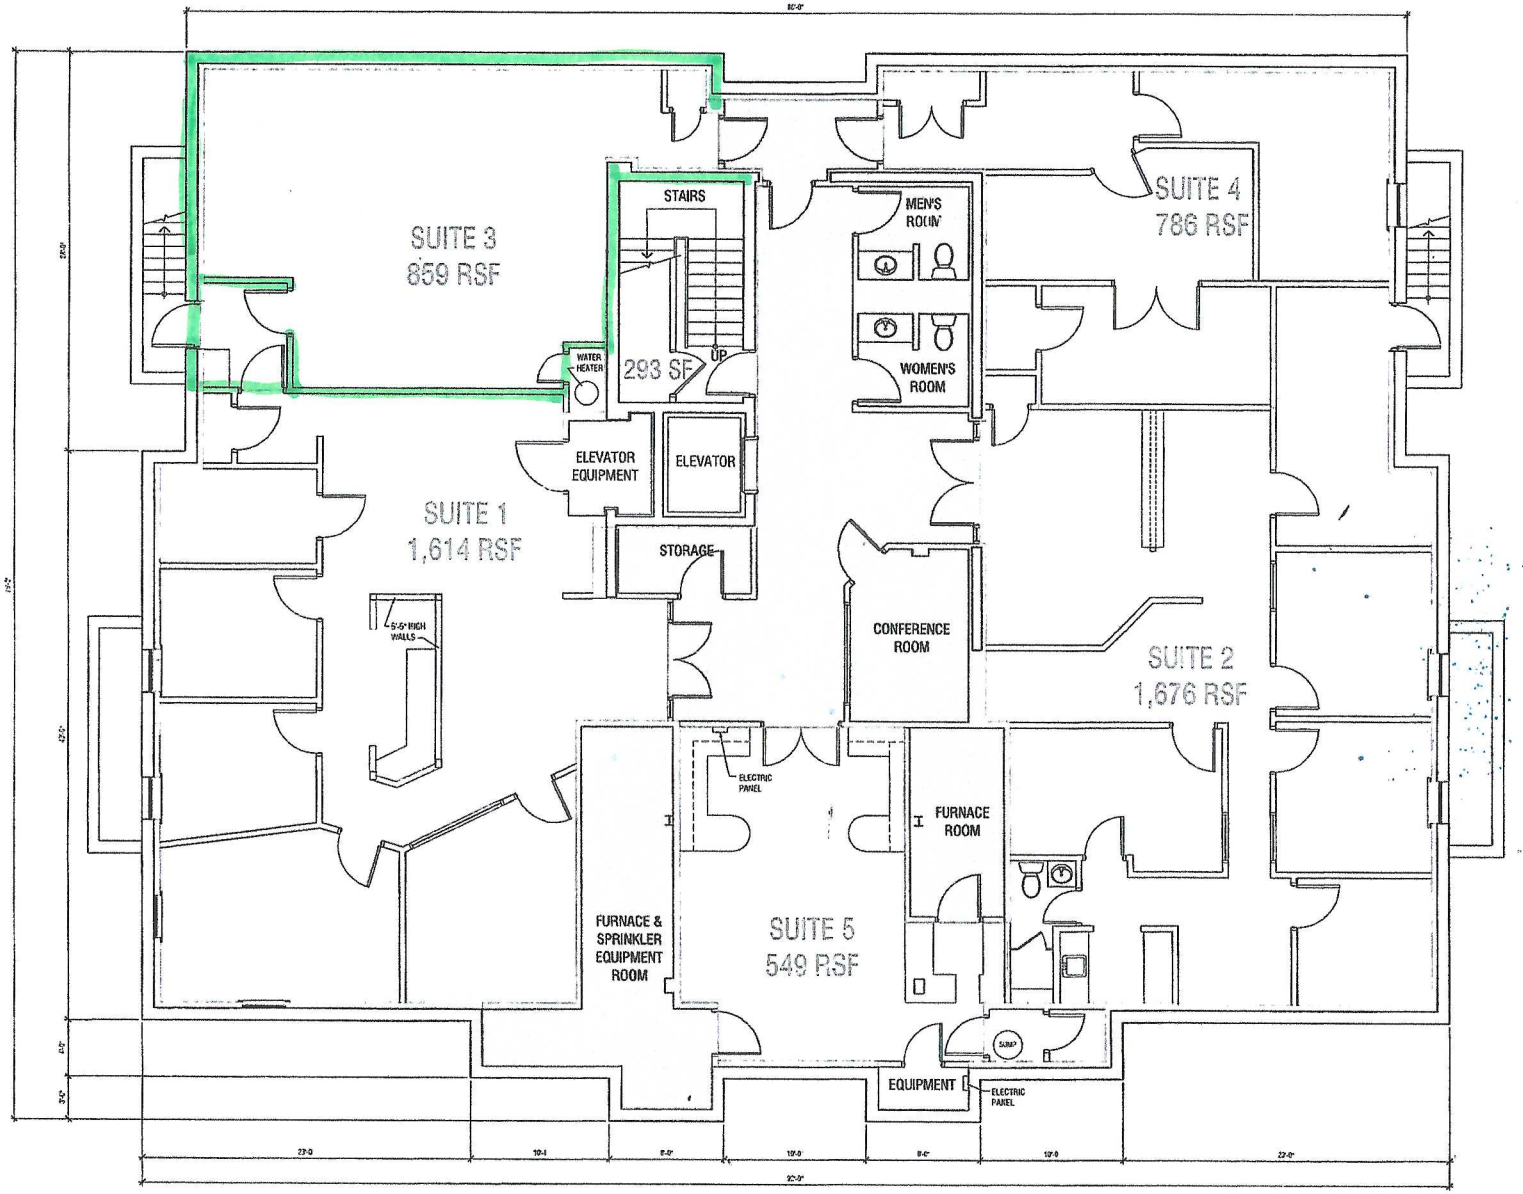

NORTH

1 A100 LOWER LEVEL FLOOR PLAN

Scale: 1/4" = 1'-0"

TMA
Architecture • Interiors • Planning
Timothy Morgan Associates LLC
1707 Shermer Road
Suite 205
Northbrook, Illinois 60062
224 • 383 • 0300 phone
224 • 383 • 0301 fax
www.timothymorganassociates.com

No.	DATE	REVISION DESCRIPTION

AS-BUILT BUILDING SURVEY
1025 W. EVERETT ROAD
LAKE FOREST, ILLINOIS

LOWER LEVEL FLOOR PLAN
RENTABLE AREA

DATE: 03/11/16

PROJECT No: 16-012

SHEET No: A100