NORTH

RAPHIC SCALE

30 60 120

(IN FEET)
1 inch = 30 ft.

EGEND:

POWER POLE
CATCH BASIN/INLET
CURB DRAIN
OVERHEAD LINES
FIB FOUND IRON BAR
DRAINAGE FLOW

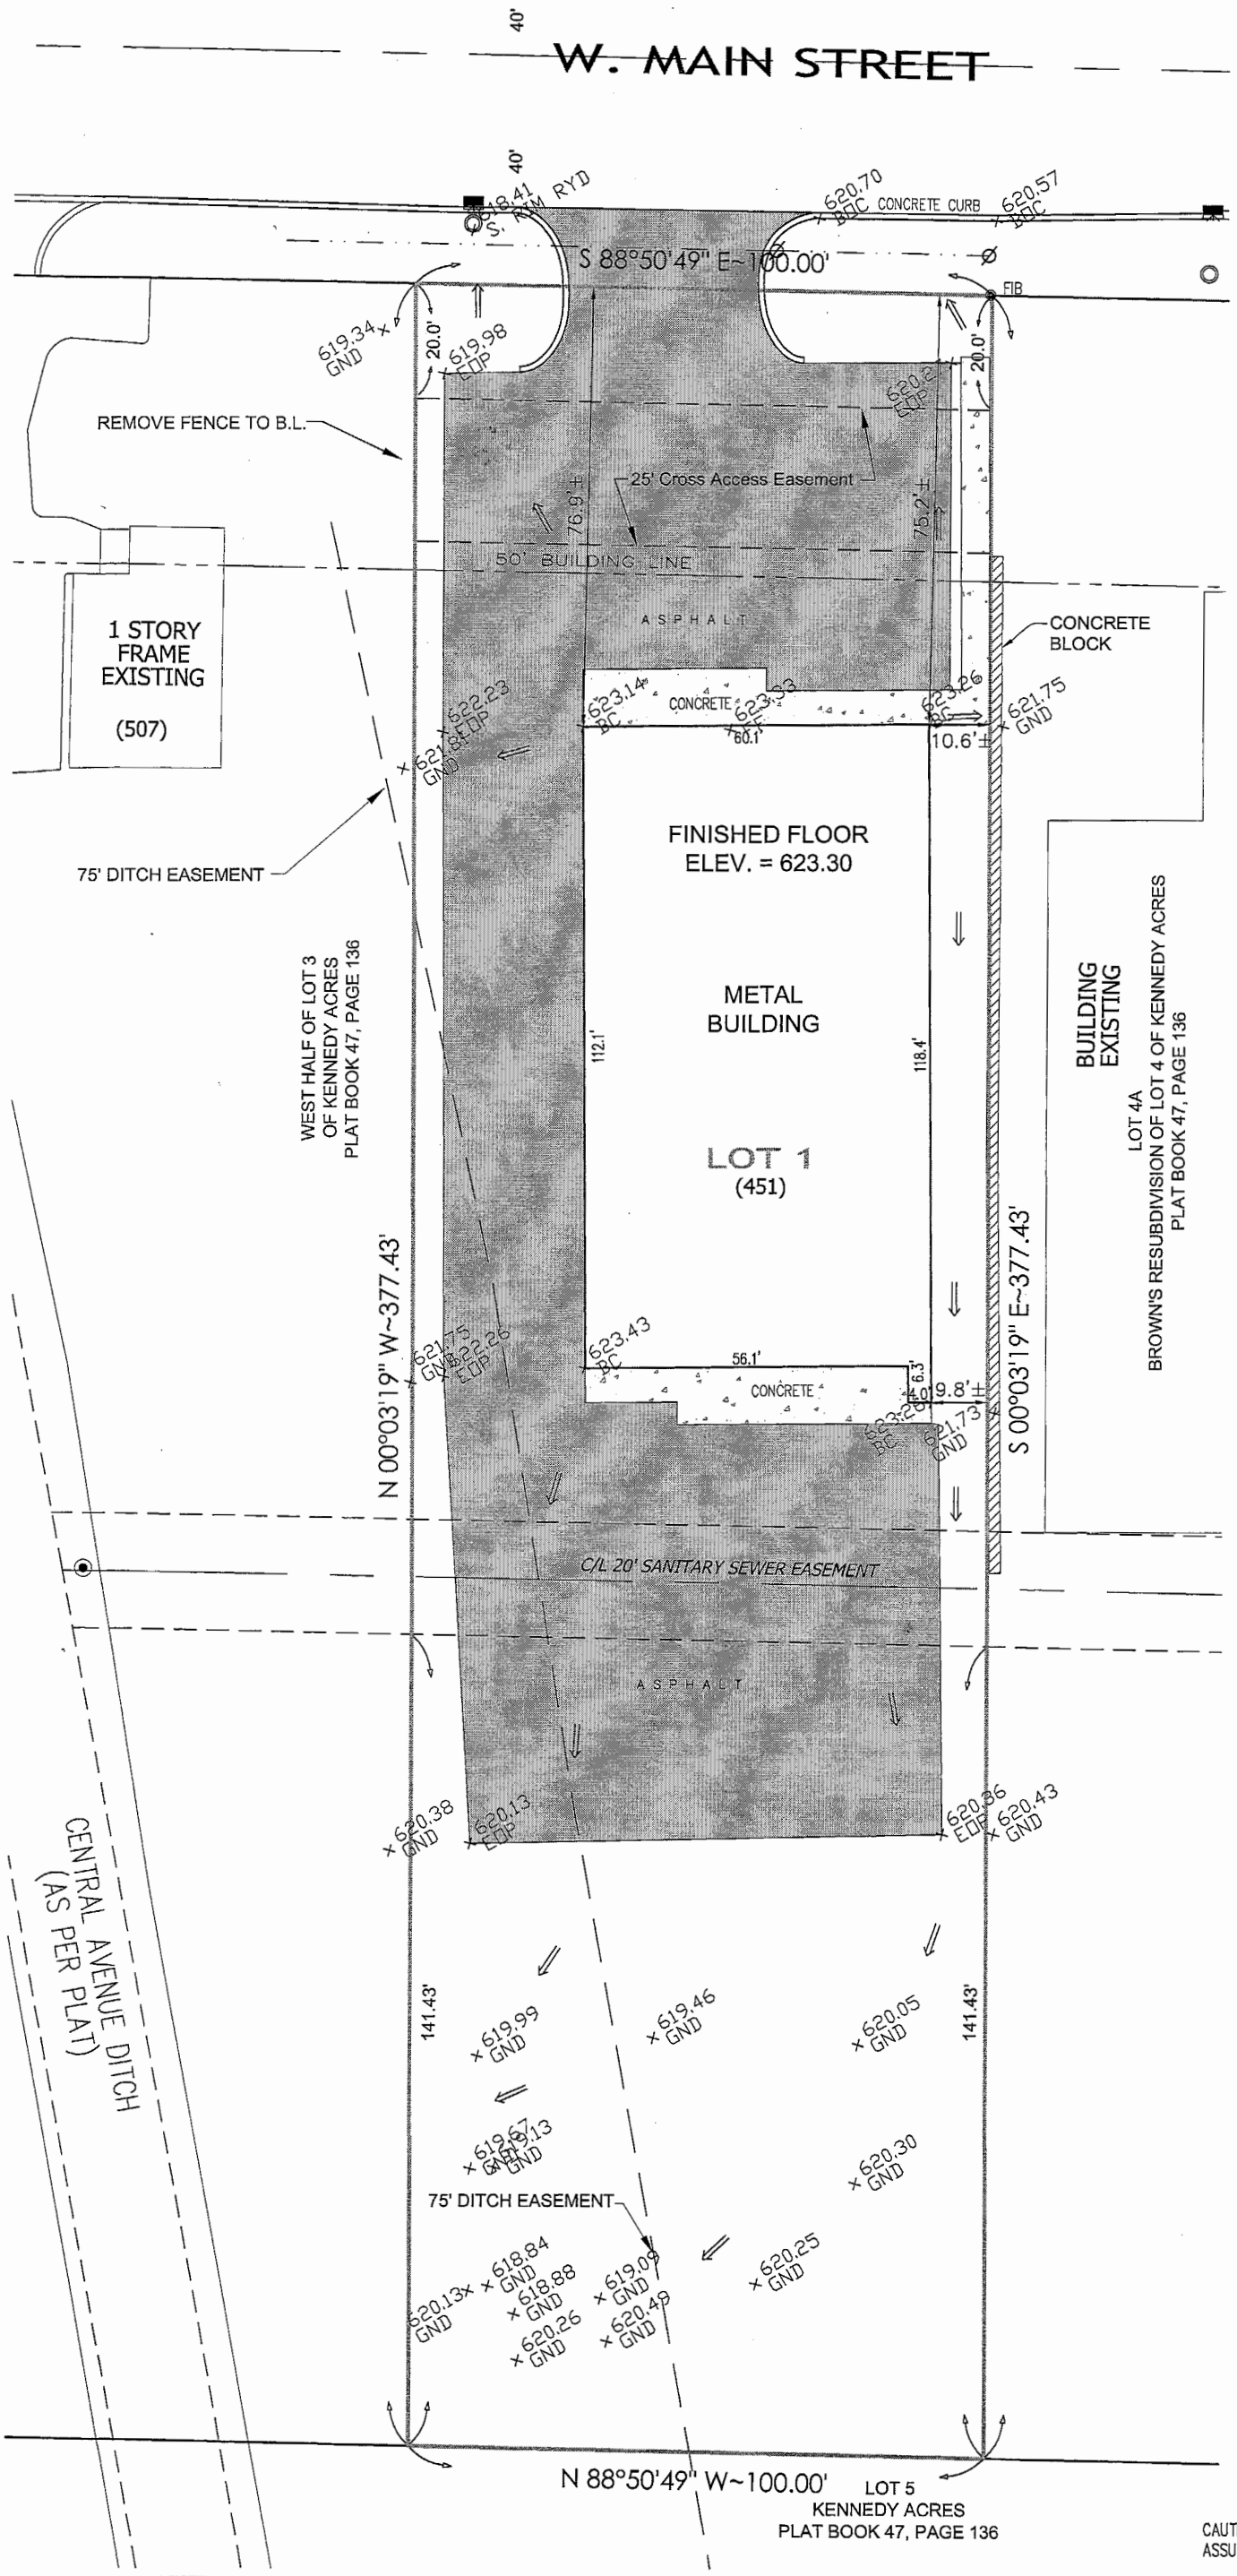

IN FLOOD ZONE "A1", AREAS OF
D ELEVATIONS AND FLOOD HAZARD
AYS AND FLOODWAY FRINGES ON THIS
URANCE RATE MAP (FIRM) DATED MAY 1,
T LOMR EFFECTIVE DATE JANUARY 8,
UMBER 180142 0005 B.

10 ELEVATION=619.99 (NGVD)-A CUT
THE SOUTH HEADWALL OF THE GRAND
DGE OVER SPRING STREET DITCH.

621.00

CAUTION: THIS RE
ASSUMED FOR TH

G

DATE: APRIL 6, 2008

LT.dwg 4/6/2009 3:41:04 PM CDT

AS BUILTS
LOT 1 ATLAS ADDITION
451 W. MAIN STREET
SCHERERVILLE, INDIANA

TOI