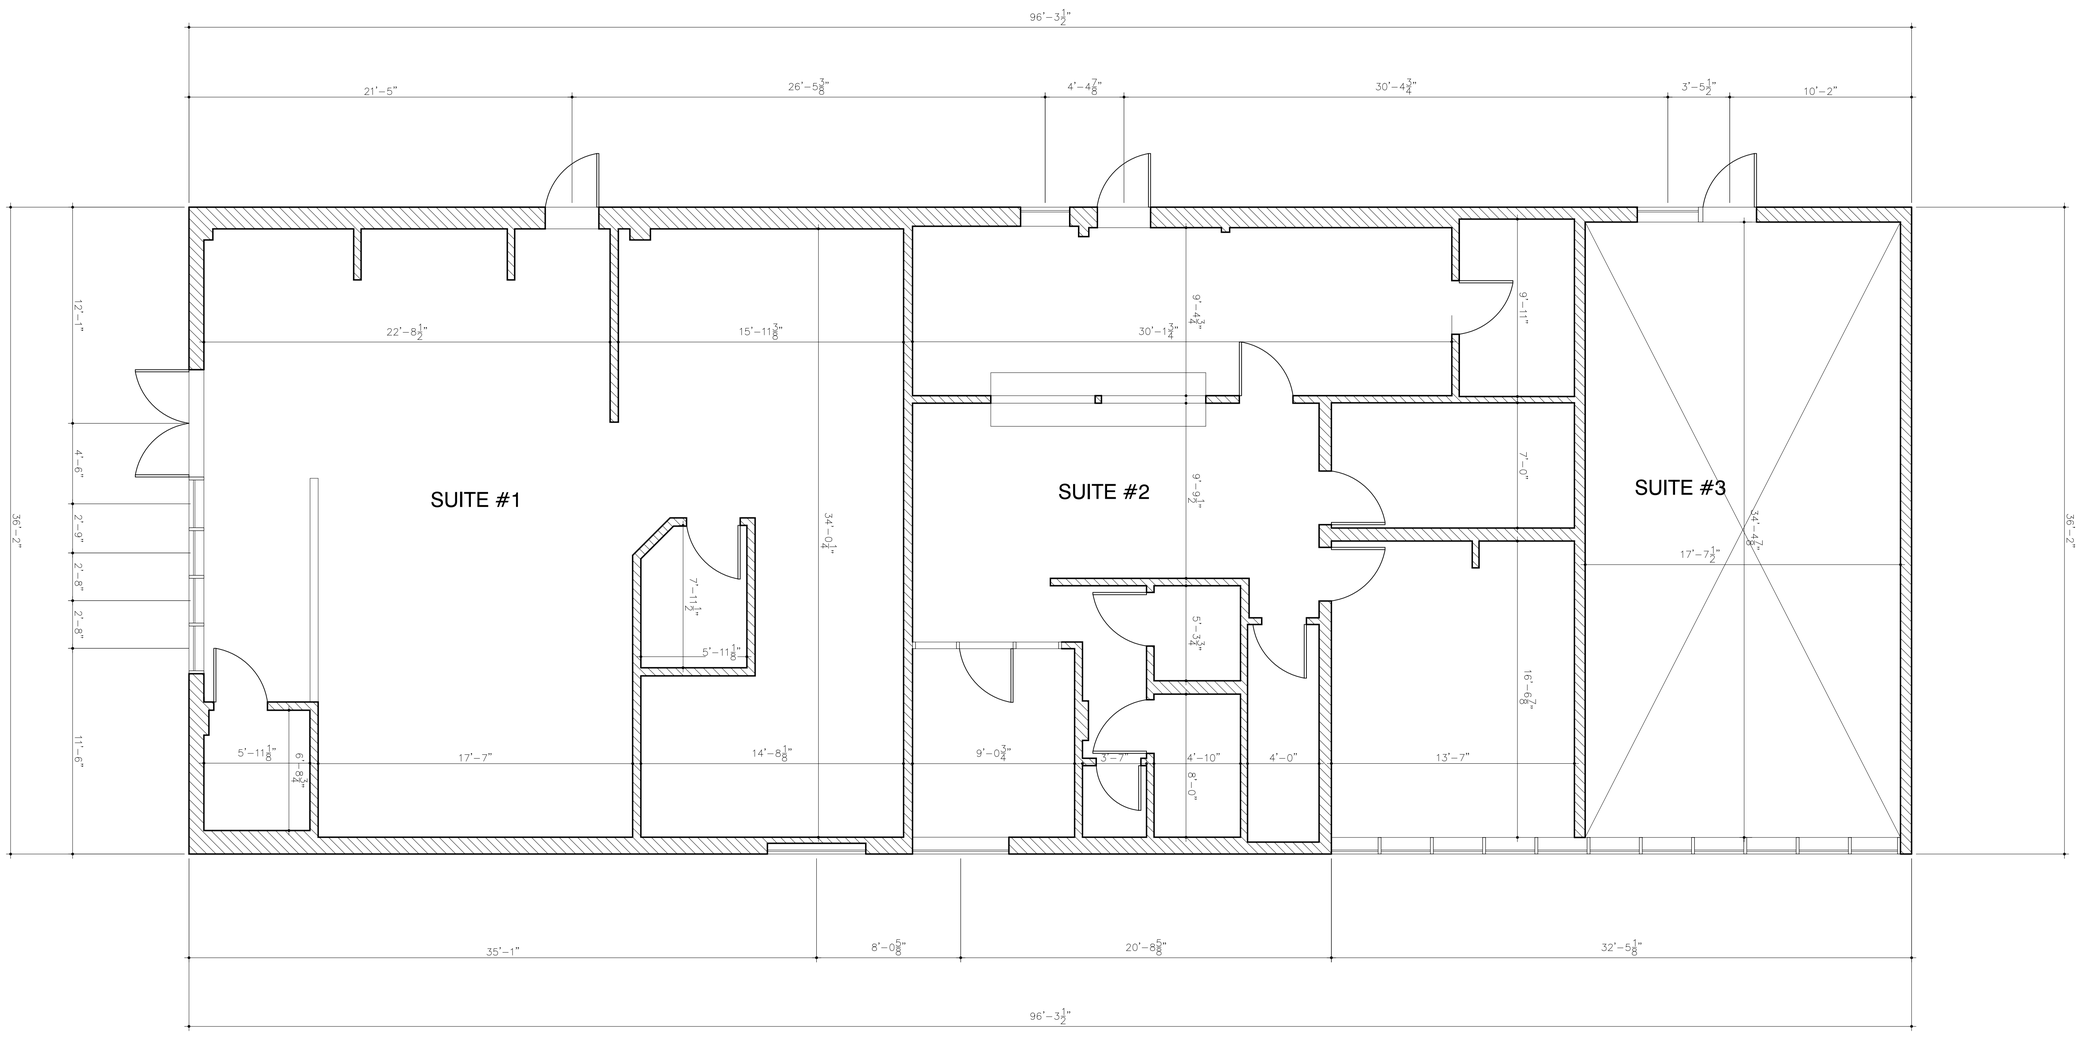

SARAH RYAN
ARCHITECT

Architect:
Sarah Ryan Architect, LLC
201 Owens Ave
St Augustine FL 32080
904.547.9430

Owner:
Alan Stevenson
Managing Partner of
Stevenson Holding Company
St. Augustine, FL 32080
alan@stevensonholdco.com

Contractor:

Structural Engineer

US 1 RETAIL
801 S PONCE DE LEON BLVD
SAINT AUGUSTINE, FL 32084

No.	Date:	Description:
1.	2-14-24	as-built floor plans

Scale AS NOTED

Sheet title

AS-BUILT PLANS

Sheet Number A100

NOT FOR CONSTRUCTION