

OFFICE BUILDING FOR SALE

SALE PRICE: SUBJECT TO OFFER



Threlkeld Building

515 WSW Loop 323, Tyler, TX 75701

- ±18,040 SF office building
- ±1,956 SF secondary building (currently used as gym)
- Flexible floor plan with multiple suite configurations
- Approximately 233 feet of Loop 323 frontage
- Exposure to approximately 40,000 vehicles per day
- Monument signage for maximum visibility
- Excellent access and exposure along one of Tyler's primary commercial corridors
- Ideal opportunity for investors or owner-users
- Located just 0.5 miles west of the Loop 323 & S. Broadway intersection
- Adjacent lot to the north also available

Philip Humber, CCIM

Associate Broker

281.382.1438

phumber@bcptx.com

Luke Swanson

Agent

903.574.5654

lswanson@bcptx.com



PROPERTY DESCRIPTION

Strategically located along Loop 323, this ±18,040 SF office building with a ±1,956 SF secondary building offers exceptional visibility and flexibility in one of Tyler's premier commercial corridors. Featuring approximately 233 feet of Loop 323 frontage, monument signage, and exposure to nearly 40,000 vehicles per day, the property provides outstanding accessibility and presence. Flexible suite configurations make it an ideal opportunity for investors or owner-users such as accounting, engineering, and law firms seeking a well-positioned commercial asset. Conveniently located just 0.5 miles west of the Loop 323 and S. Broadway intersection, an adjacent lot to the north is also available for additional expansion or development potential.

OFFERING SUMMARY

Sale Price:	Subject To Offer
Building Size:	19,996 SF

DEMOGRAPHICS	0.25 MILES	0.5 MILES	1 MILE
Total Households	188	716	3,224
Total Population	425	1,666	7,752
Average HH Income	\$131,281	\$122,462	\$97,391

Philip Humber, CCIM

Associate Broker

281.382.1438

phumber@bcptx.com

Luke Swanson


Agent

903.574.5654

lswanson@bcptx.com



**BURNS
COMMERCIAL
PROPERTIES**

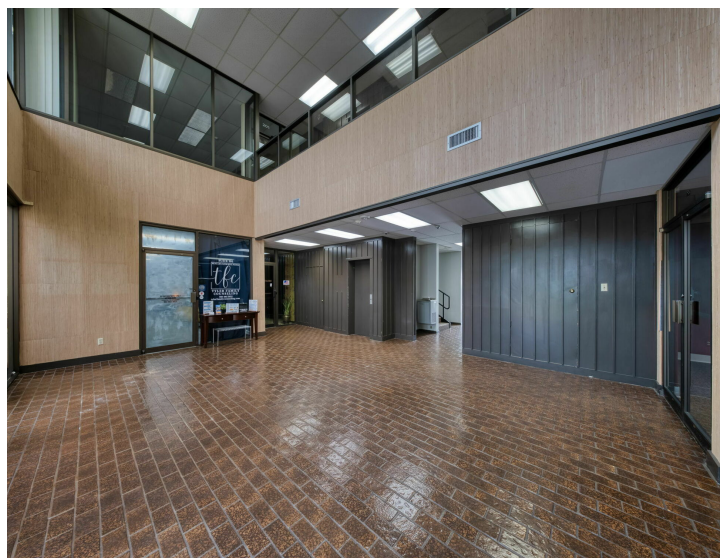

Philip Humber, CCIM

Associate Broker

281.382.1438

phumber@bcptx.com

Luke Swanson


Agent

903.574.5654

lswanson@bcptx.com



**BURNS
COMMERCIAL
PROPERTIES**

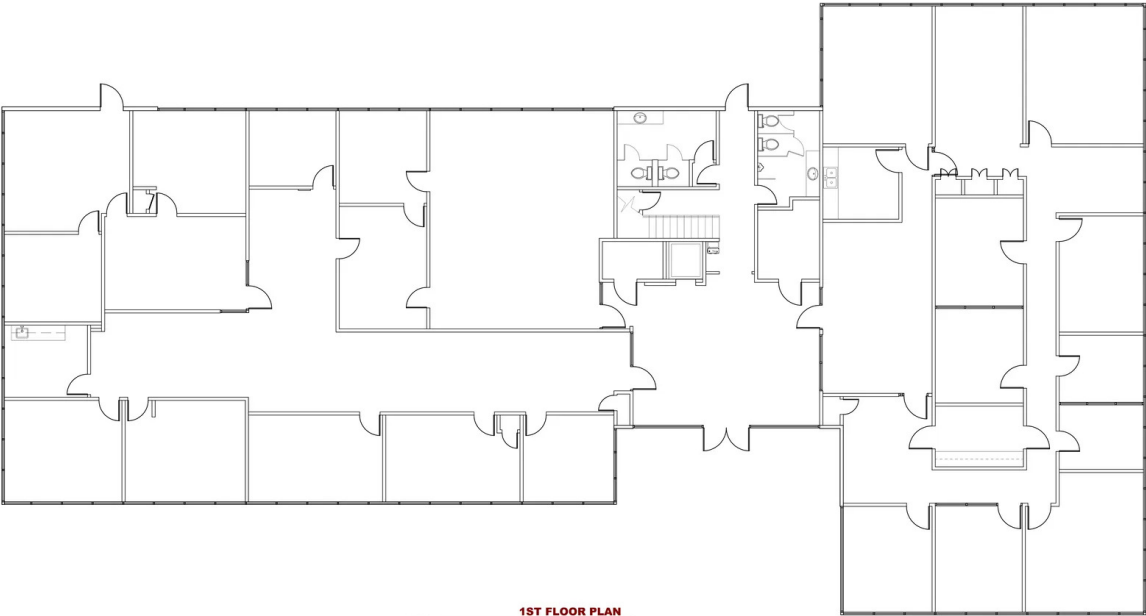

1 **1ST FLOOR PLAN**
scale: 3/16" = 1'-0"
8607 SF.



FranklinZed Studios, Inc.
P.O. BOX 8026
TYLER, TX 75711
903-625-9564

NOT FOR
REGULATORY
APPROVAL
OR
CONSTRUCTION

REVISION	DATE	BY	DESCRIPTION
1	03/08/23	LS	EXISTING 1ST FLOOR PLAN

**AS-BUILTS
FOR
515 WSW LOOP 323**

TYLER, TX

Sheet Title
**EXISTING
1st FLOOR PLAN**


Date
03/08/23

Sheet No.
A2.00

Philip Humber, CCIM
Associate Broker
281.382.1438
phumber@bcptx.com

Luke Swanson
Agent
903.574.5654
lswanson@bcptx.com



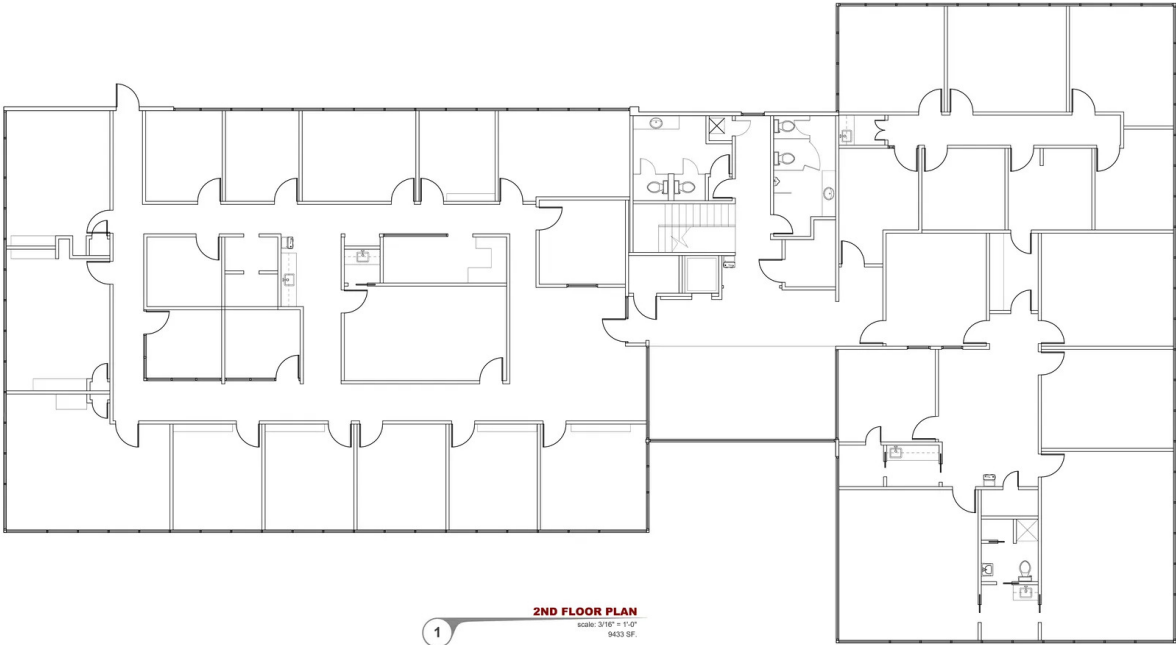



FranklinZed Studios, Inc.
P.O. BOX 8026
TYLER, TX 75711
903-625-9564

NOT FOR
REGULATORY
APPROVAL
OR
CONSTRUCTION

REVISION	DATE	BY	CHKD
1	03/08/23	LS	PH

**AS-BUILTS
FOR
515 WSW LOOP 323**
TYLER, TX

Sheet Title
**EXISTING
2nd FLOOR PLAN**


Date
03/08/23

Sheet No.
A2.01

Philip Humber, CCIM
Associate Broker
281.382.1438
phumber@bcptx.com

Luke Swanson
Agent
903.574.5654
lswanson@bcptx.com

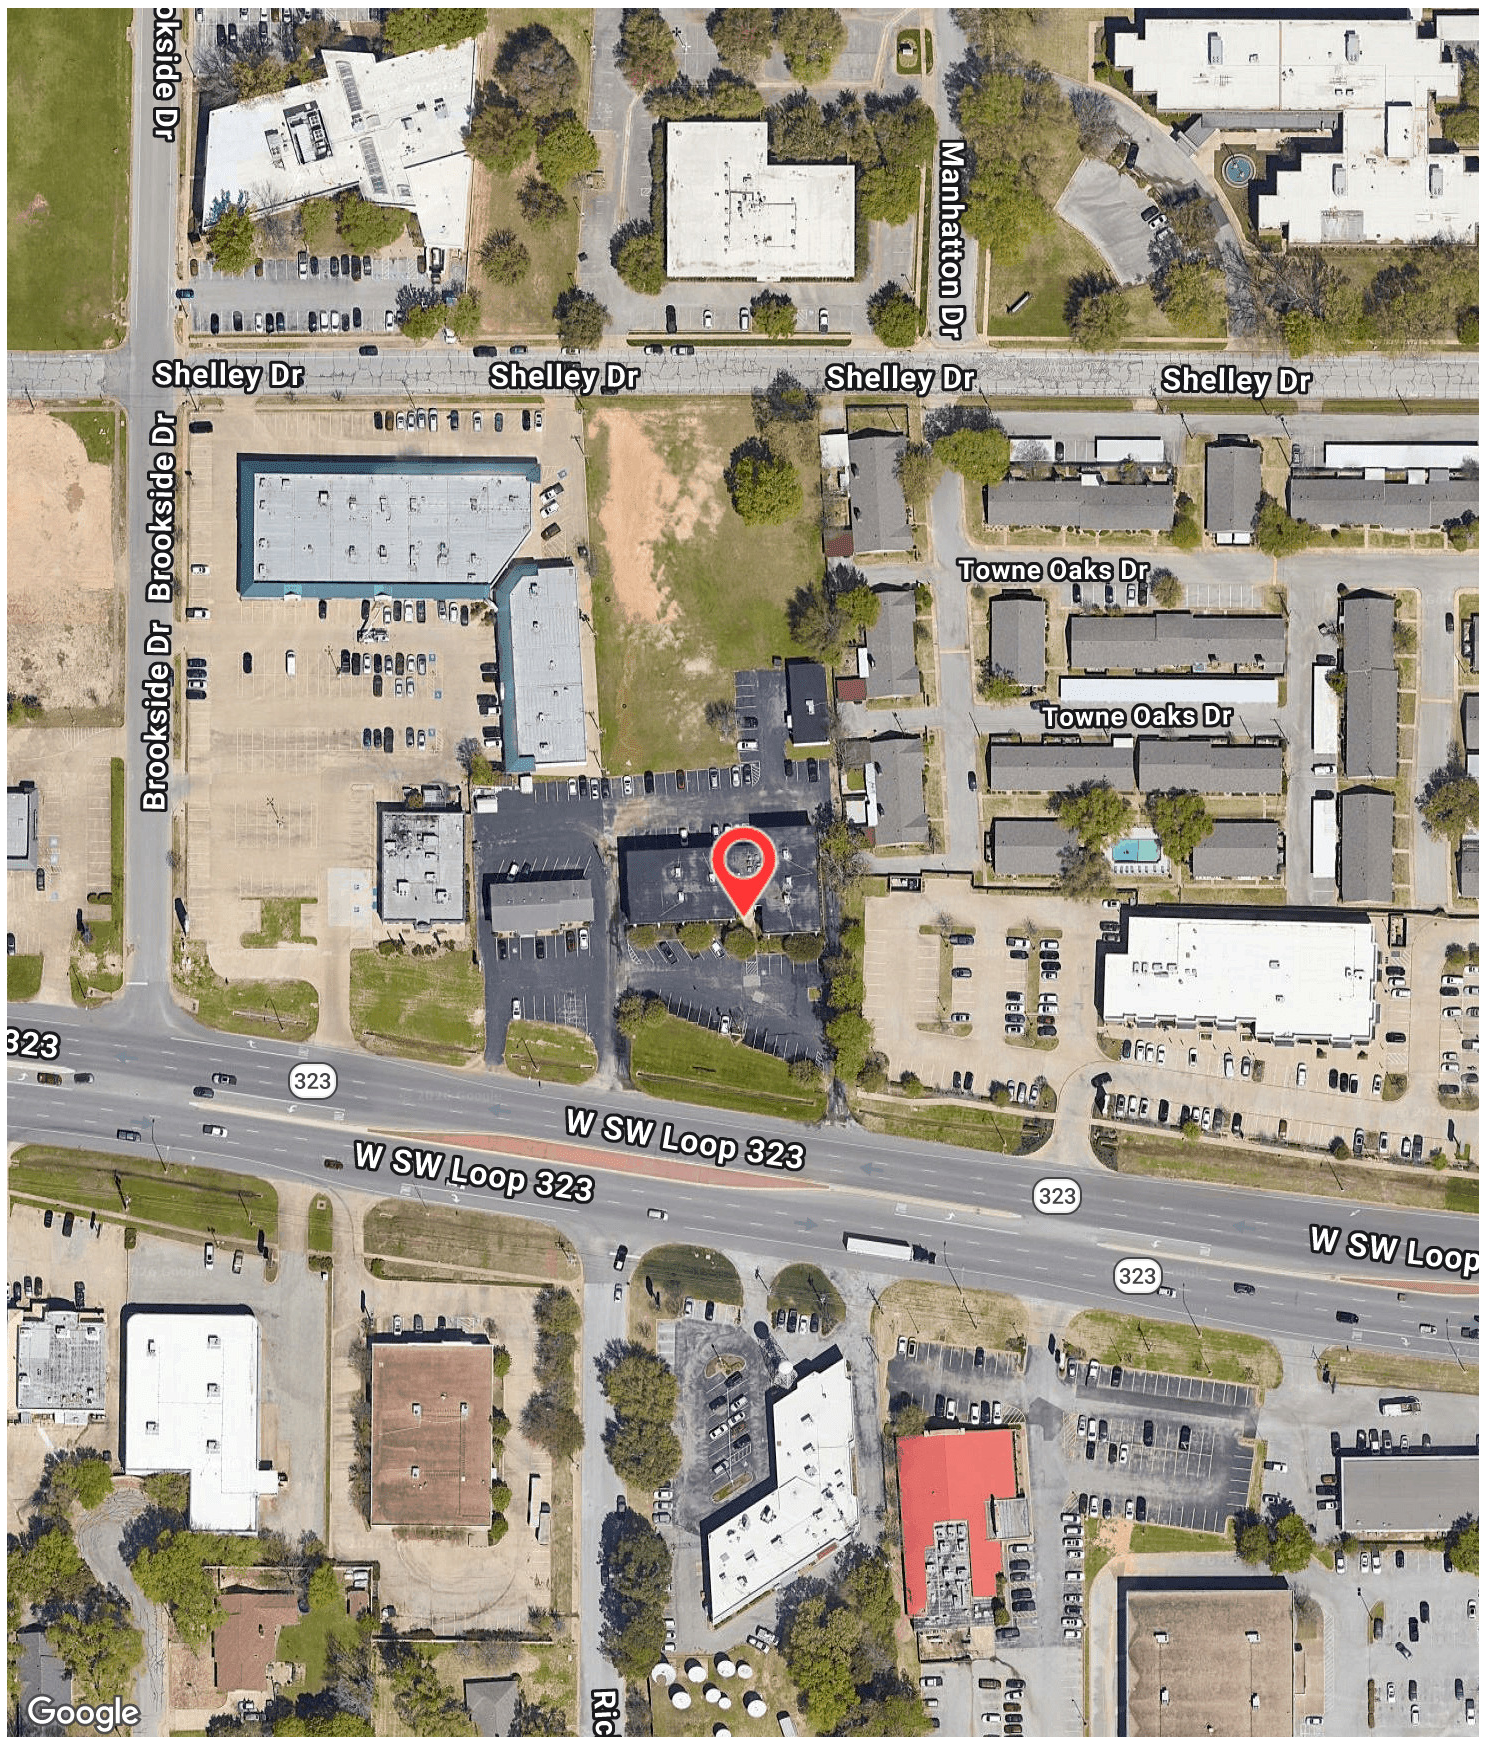

**Philip Humber, CCIM**

Associate Broker

281.382.1438

phumber@bcptx.com

Luke Swanson

Agent

903.574.5654

lswanson@bcptx.com

BCP**BURNS
COMMERCIAL
PROPERTIES**



Information About Brokerage Services

Texas law requires all real estate license holders to give the following information about brokerage services to prospective buyers, tenants, sellers and landlords.

2-10-2025



TYPES OF REAL ESTATE LICENSE HOLDERS:

- **A BROKER** is responsible for all brokerage activities, including acts performed by sales agents sponsored by the broker.
- **A SALES AGENT** must be sponsored by a broker and works with clients on behalf of the broker.

A BROKER'S MINIMUM DUTIES REQUIRED BY LAW (A client is the person or party that the broker represents):

- Put the interests of the client above all others, including the broker's own interests;
- Inform the client of any material information about the property or transaction received by the broker;
- Answer the client's questions and present any offer to or counter-offer from the client; and
- Treat all parties to a real estate transaction honestly and fairly.

A LICENSE HOLDER CAN REPRESENT A PARTY IN A REAL ESTATE TRANSACTION:

AS AGENT FOR OWNER (SELLER/LANDLORD): The broker becomes the property owner's agent through an agreement with the owner, usually in a written listing to sell or property management agreement. An owner's agent must perform the broker's minimum duties above and must inform the owner of any material information about the property or transaction known by the agent, including information disclosed to the agent or subagent by the buyer or buyer's agent. **An owner's agent fees are not set by law and are fully negotiable.**

AS AGENT FOR BUYER/TENANT: The broker becomes the buyer/tenant's agent by agreeing to represent the buyer, usually through a written representation agreement. A buyer's agent must perform the broker's minimum duties above and must inform the buyer of any material information about the property or transaction known by the agent, including information disclosed to the agent by the seller or seller's agent. **A buyer/tenant's agent fees are not set by law and are fully negotiable.**

AS AGENT FOR BOTH - INTERMEDIARY: To act as an intermediary between the parties the broker must first obtain the written agreement of *each party* to the transaction. The written agreement must state who will pay the broker and, in conspicuous bold or underlined print, set forth the broker's obligations as an intermediary. A broker who acts as an intermediary:

- Must treat all parties to the transaction impartially and fairly;
- May, with the parties' written consent, appoint a different license holder associated with the broker to each party (owner and buyer) to communicate with, provide opinions and advice to, and carry out the instructions of each party to the transaction.
- Must not, unless specifically authorized in writing to do so by the party, disclose:
 - that the owner will accept a price less than the written asking price;
 - that the buyer/tenant will pay a price greater than the price submitted in a written offer; and
 - any confidential information or any other information that a party specifically instructs the broker in writing not to disclose, unless required to do so by law.

AS SUBAGENT: A license holder acts as a subagent when aiding a buyer in a transaction without an agreement to represent the buyer. A subagent can assist the buyer but does not represent the buyer and must place the interests of the owner first.

TO AVOID DISPUTES, ALL AGREEMENTS BETWEEN YOU AND A BROKER SHOULD BE IN WRITING AND CLEARLY ESTABLISH:

- The broker's duties and responsibilities to you, and your obligations under the representation agreement.
- Who will pay the broker for services provided to you, when payment will be made and how the payment will be calculated.

LICENSE HOLDER CONTACT INFORMATION: This notice is being provided for information purposes. It does not create an obligation for you to use the broker's services. Please acknowledge receipt of this notice below and retain a copy for your records.

Burns Commercial Properties, LLC	592818		(903) 534-1200
Licensed Broker /Broker Firm Name or Primary Assumed Business Name	License No.	Email	Phone
Mark Whatley	423898	mwhatley@bcptx.com	(903) 530-0955
Designated Broker of Firm	License No.	Email	Phone
Licensed Supervisor of Sales Agent/ Associate	License No.	Email	Phone
Philip Humber	675335	phumber@bcptx.com	(281) 382-1438
Sales Agent/Associate's Name	License No.	Email	Phone

Buyer/Tenant/Seller/Landlord Initials

Date

Regulated by the Texas Real Estate Commission

Information available at www.trec.texas.gov

Philip Humber, CCIM

Associate Broker

281.382.1438

phumber@bcptx.com

Luke Swanson

Agent

903.574.5654

lswanson@bcptx.com



**BURNS
COMMERCIAL
PROPERTIES**